

ISP AS-BUILT PLAN – GOJISPA WILLOWBRIDGE

Project Details		Install Date	2023/08/17
End-User Name	Gojiswa		
Link Africa Customer Name:	Vox Telecommunications (Pty) Ltd		
	Name	Contact Number	Email Address
Representative: Link Africa Planner	Sibusiso Chiliza	0711724267	sibusiso@linkafrica.co.za
Representative: Link Africa Permissions			
Representative: Customer			
Representative: Landlord	Axel	021 914 7218	maintenance@willowbridgecentre.co.za

ISP EXECUTIONS:

- Fibre route (Red)

- Install 70m 1way micro duct from Telkom room to the front of Rocomamas.
- Install 60m x 20mm Pvc conduit on top of the roof along the wall.
- Install 1m 20mm Bosal pipe.
- Install 1m spreg.
- Drill a hole through to the ceiling.
- Install 150m 4f drop cable from LA Cabinet in Telkom room to Gojiswa.
- Install ATB & ONT in the DB cupboard at the reception.
- Label duct & cables.
- Provide OTDR traces , Power meter & Pictures.

Note: This project should be done in conjunction with Landlord & Client

AS_BUILT PLAN

Edina
18 August 2023

Site Details

Site Name:	Willowbridge Mall				
Co-ordinates:	Latts:	-33.869823	Longs:	18.631531	
Site Address:	WILLOWBRIDGE LIFESTYLE CENTRE,39 Carl Cronje Dr, Bellville Park, Cape Town, 7530,				
Suburb:	Bellville				
Floor Number:		Room Number:		Site No.:	
Cabinet Position:	Cupboard				
Building Name:	Willowbridge Mall		Site ID		
Site Type:	X	Single		Duel	Site Location:
					Rooftop
					Green Field
					X
					In Building
Site Owner:					

Possible concerns that must be flagged to Landlord/Customer

Customer deliverables:

- Personnel access to secure areas for build and maintenance phases.
- Permission for proposed construction.

Site Planning Approved by Landlord/Building Owner/Manager



Signature:

Name:

Designation:

Email.:


Contact No: Date:

Planner Name	Project No:	 	Region
Sibusiso Chiliza	99W0057239		WC
PROJECT DESCRIPTION: Provide fibre Infrastructure from Link Africa Cabinet in the Telkom room to Gojiswa			Date Compiled
			2023/09/14
			Page 1 of 8



Splice drop cable on the panel-row 4 & patch on the splitter-row 5

1

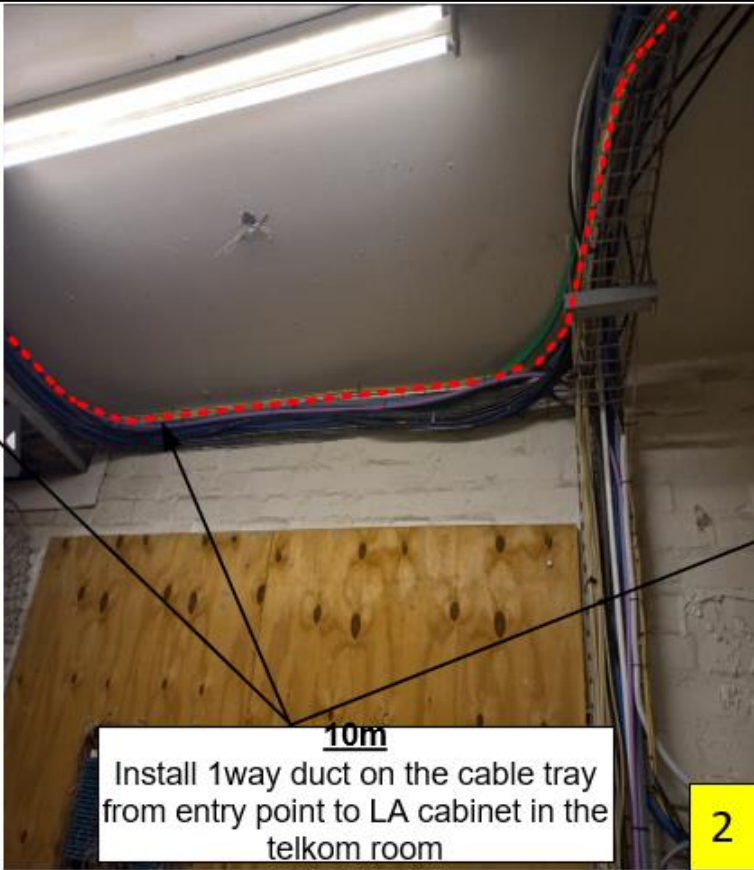

10m
Install 1way duct on the cable tray from entry point to LA cabinet in the telkom room

2




3



4




5

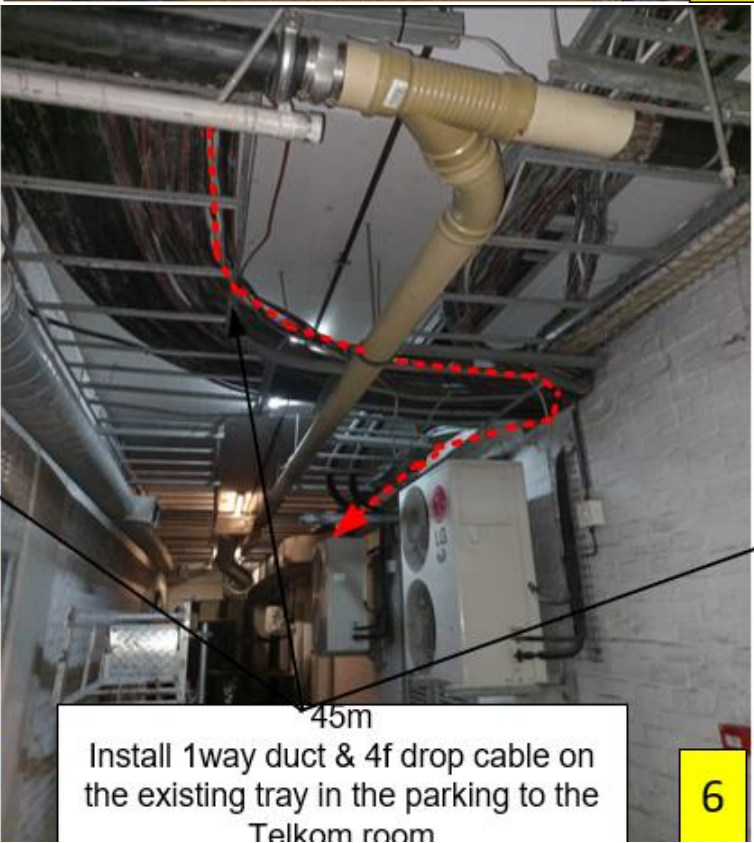

45m
Install 1way duct & 4f drop cable on the existing tray in the parking to the Telkom room

6

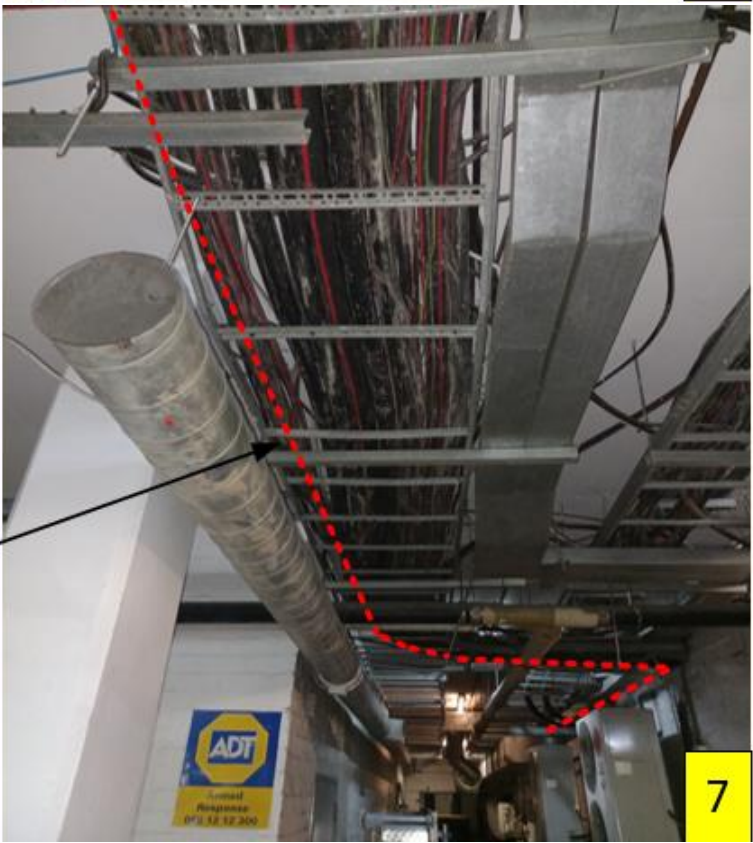

7



8

Color Legend					
	Existing Access Fibre		Existing Fibre Distribution/Termination Point (FDP/FTP)		New Kicker Block
	Proposed entry route 1 into building.		New Fibre Distribution/Termination Point (FDP/FTP)		Existing Kicker Block
	Proposed entry route 2 into building.		Existing Junction Box		Existing Service Duct
	Existing 3 rd Party Cable		New Junction Box		Existing LA Duct
	Existing HH		Existing Optical Distribution Unit (ODU)		Existing Sewer Pipe
	New HH Route 1		New Optical Distribution Unit (ODU)		Existing Stormwater Pipe
	New HH Route 2		Core Drill		New Bosal or Agri Pipe
	Existing Draw Box		Sprag		Existing Bosal or Agri Pipe
	New Draw Box - Route 1		New Link Africa MH		New ATB
	New Draw Box - Route 2		Existing Link Africa MH		New Client raiscom/ME1200

REVISION							REGION: WC
No.	NATURE OF REVISION	DATE	SIGNATURE	AUTHORITY			
1							
2							
3							
SCALE:		PLANNED BY:		PROJECT No:	PROJECT DESCRIPTION:		Date Compiled 2023/09/14
N.T.S. (Not To Scale)		Sibusiso Chiliza		99W0057239	Provide fibre Infrastructure from Link Africa Cabinet in the Telkom room to Gojsipa		Page 2 of 8



9



10




11



12





13

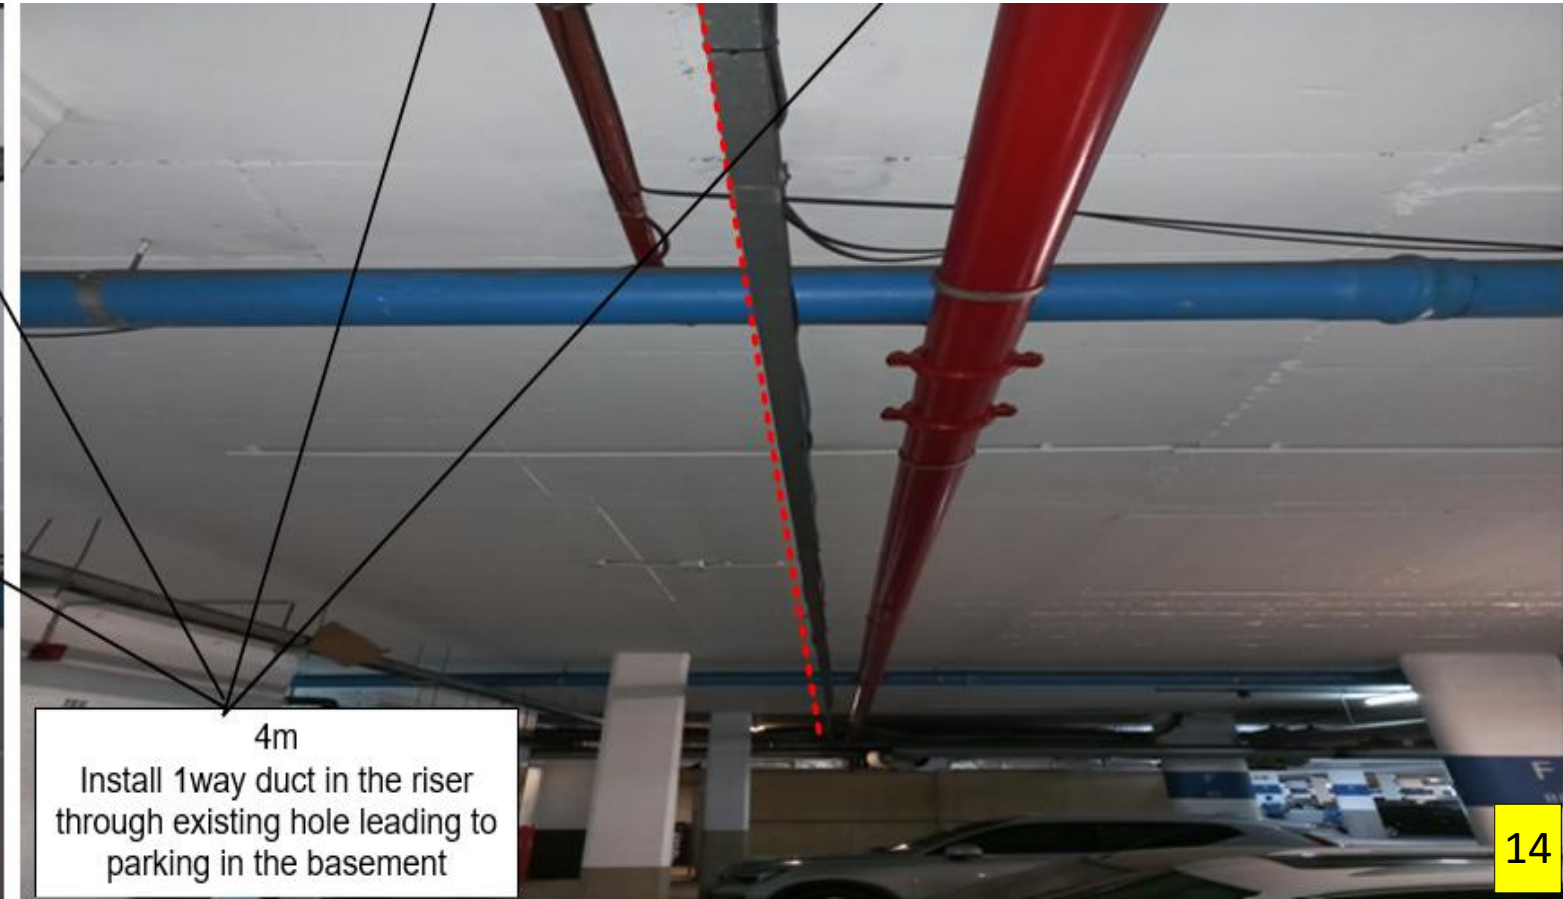

14





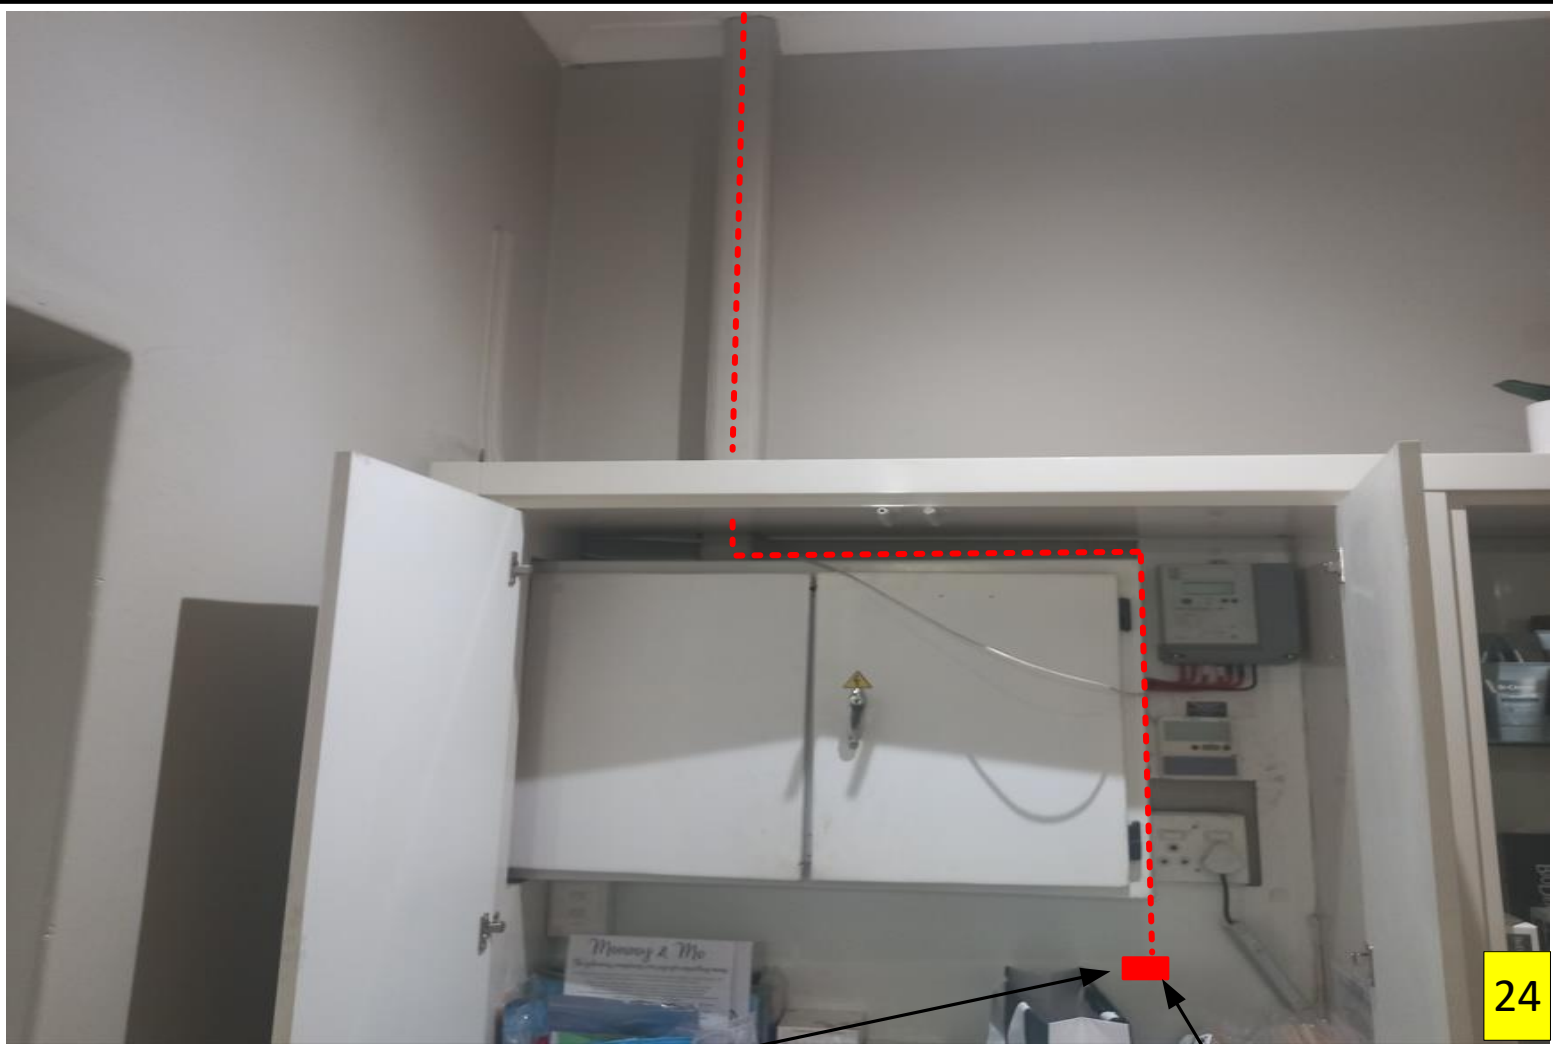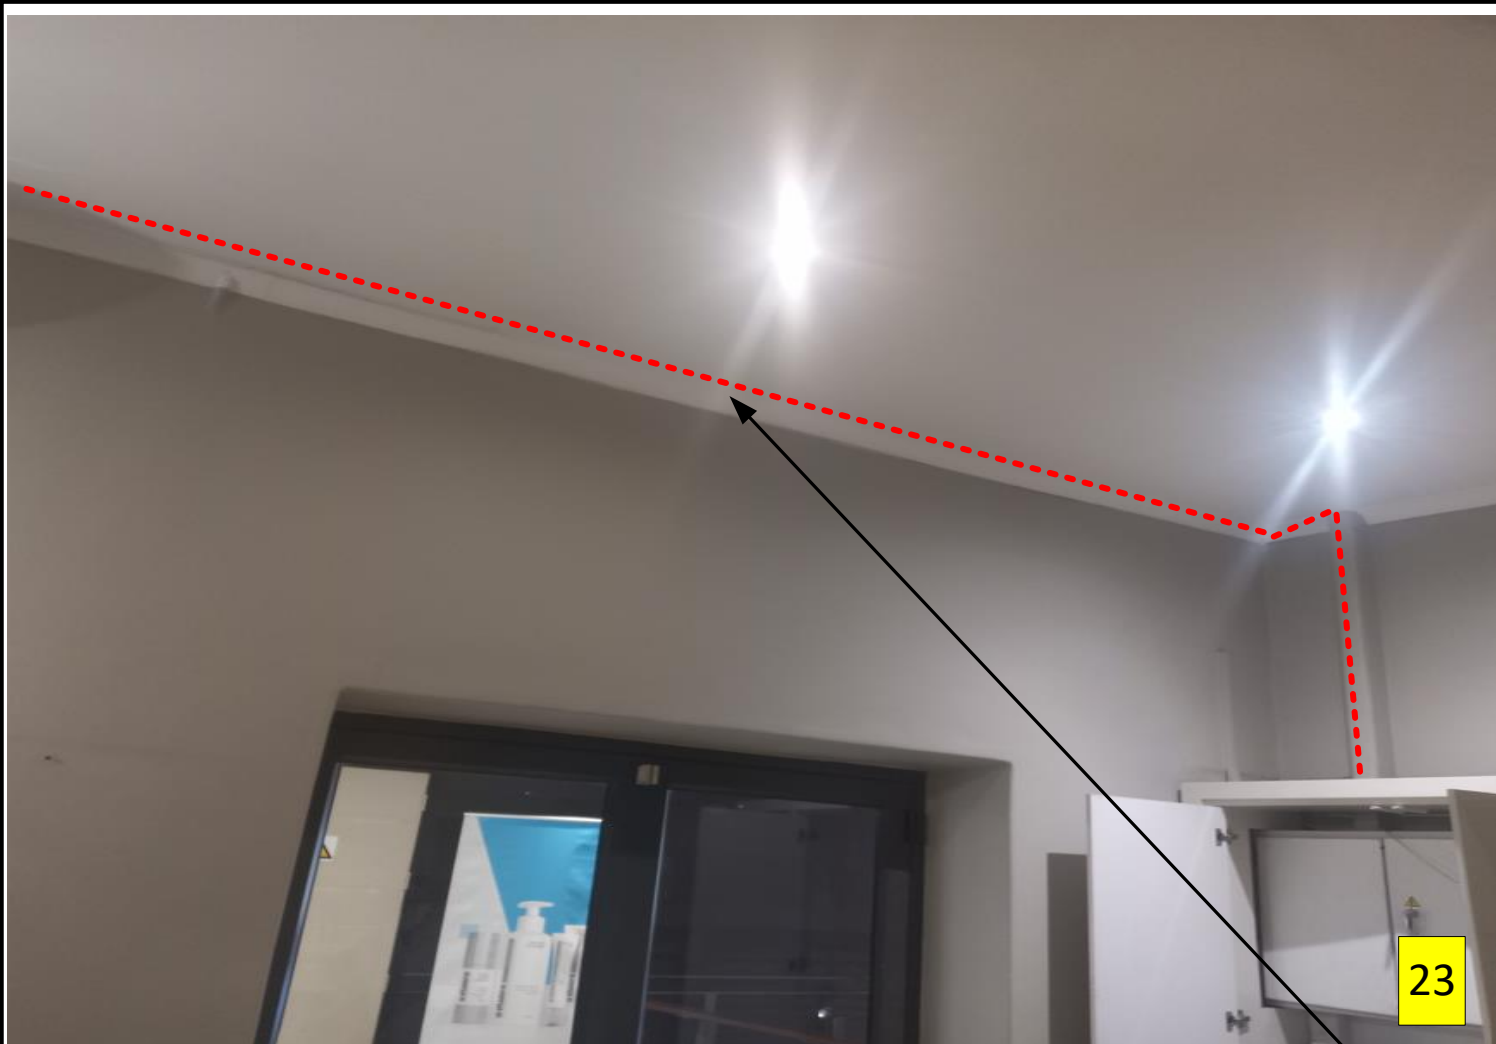

















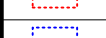




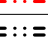






4m
Install 1way duct in the riser
through existing hole leading to
parking in the basement

Color Legend							REVISION							REGION:	
	Existing Access Fibre		Existing Fibre Distribution/Termination Point (FDP/FTP)		New Kicker Block		No.	NATURE OF REVISION	DATE	SIGNATURE	AUTHORITY			WC	
	Proposed entry route 1 into building.		New Fibre Distribution/Termination Point (FDP/FTP)		Existing Kicker Block		1								
	Proposed entry route 2 into building.		Existing Junction Box		Existing Service Duct		2								
	Existing 3rd Party Cable		New Junction Box		Existing LA Duct		3								
	Existing HH		Existing Optical Distribution Unit (ODU)		Existing Sewer Pipe		SCALE:		PLANNED BY:		PROJECT No:			PROJECT DESCRIPTION:	
	New HH Route 1		New Optical Distribution Unit (ODU)		Existing Stormwater Pipe	N.T.S. (Not To Scale)		Sibusiso Chiliza		99W0057239		Provide fibre Infrastructure from Link Africa Cabinet in the Telkom room to Gojispa		2023/09/14	
	New HH Route 2		Core Drill		New Bosal or Agri Pipe									Page 3 of 8	
	Existing Draw Box		Sprag		Existing Bosal or Agri Pipe										
	New Draw Box - Route 1		New Link Africa MH		New ATB										
	New Draw Box - Route 2		Existing Link Africa MH		CPE New Client raiscom/ME1200										





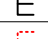


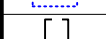



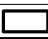



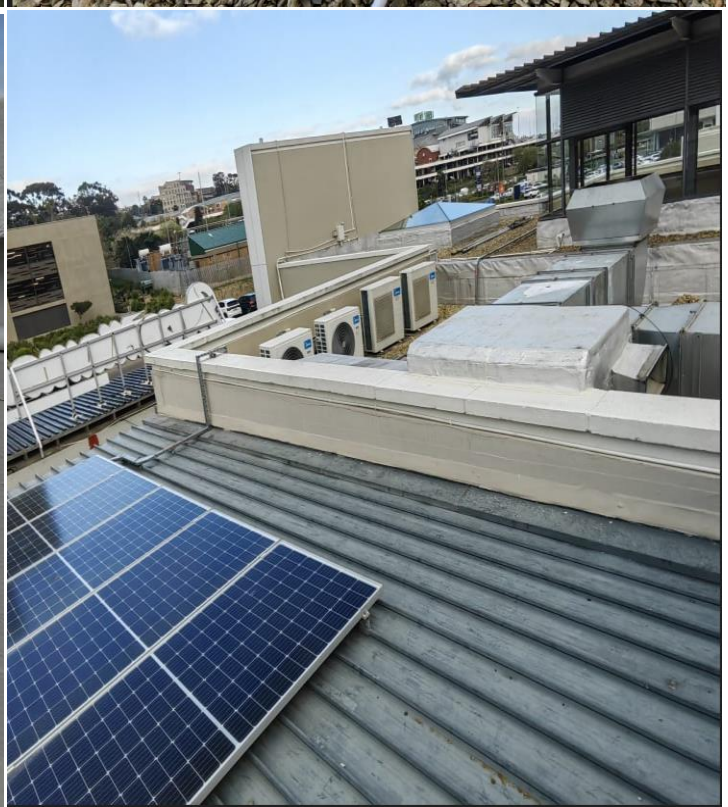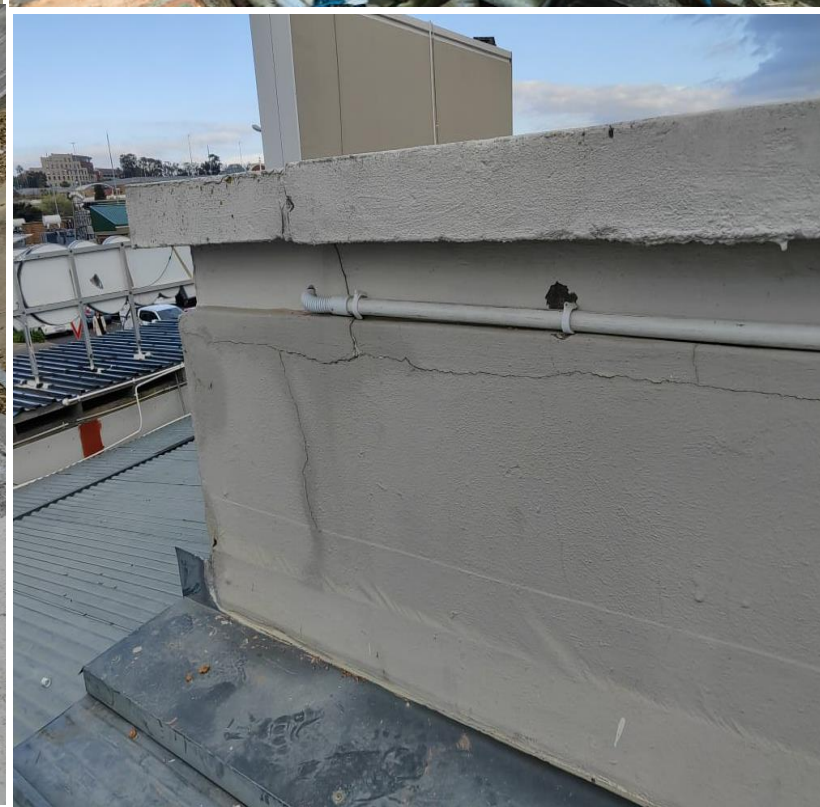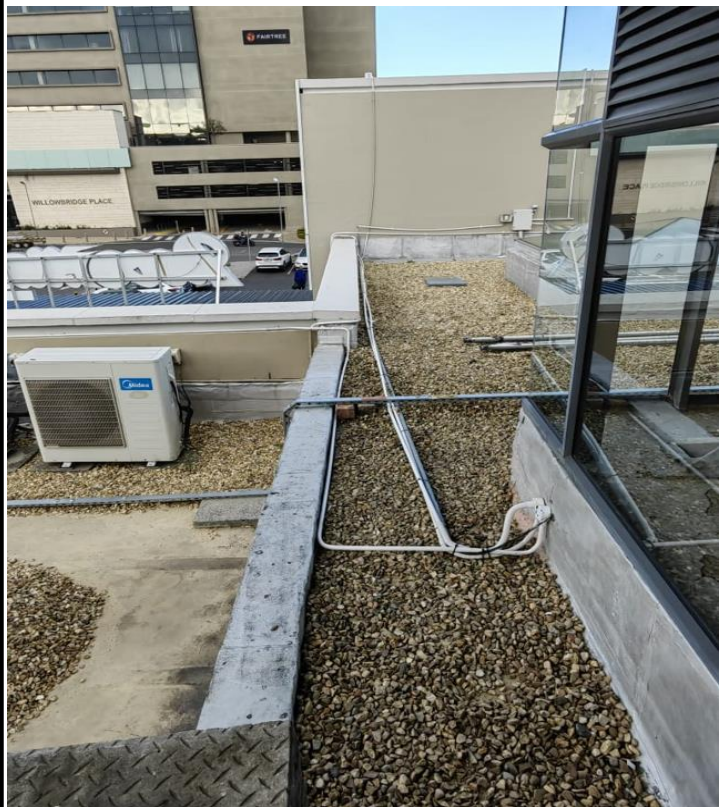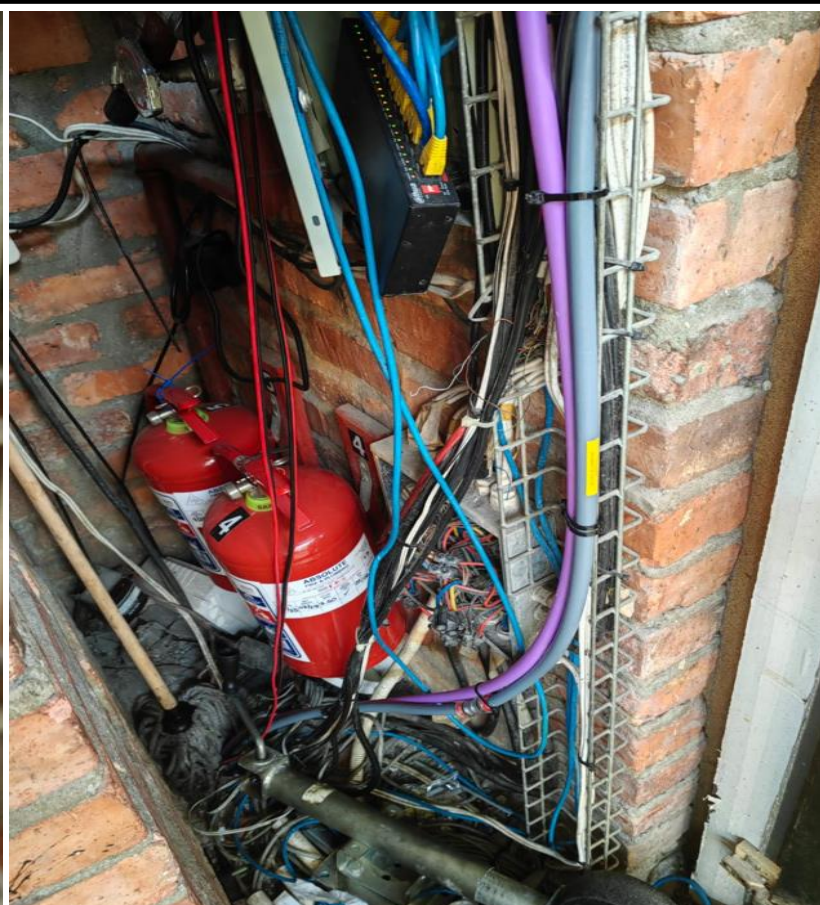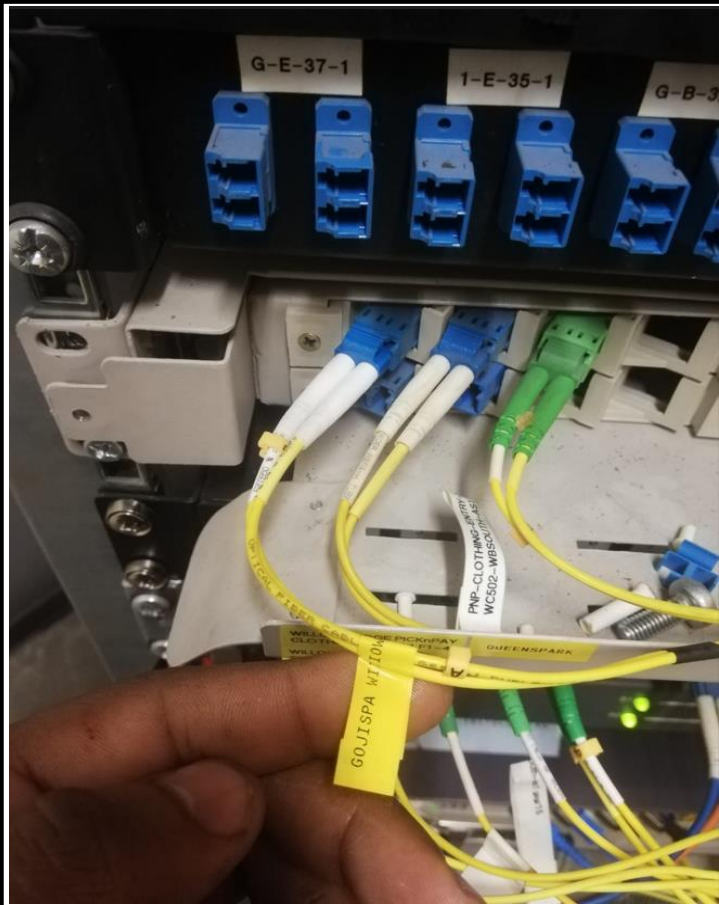



 


















 
4m
Install 1way duct & 4f drop cable
Terminate in the DB cupboard at the
reception


New termination point

Color Legend						REVISION							REGION:
No.	NATURE OF REVISION	DATE	SIGNATURE	AUTHORITY									
	Existing Access Fibre		Existing Fibre Distribution/Termination Point (FDP/FTP)		New Kicker Block	1							WC
	Proposed entry route 1 into building.		New Fibre Distribution/Termination Point (FDP/FTP)		Existing Kicker Block	2							
	Proposed entry route 2 into building.		Existing Junction Box		Existing Service Duct	3							
	Existing 3 rd Party Cable		New Junction Box		Existing LA Duct								
	Existing HH		Existing Optical Distribution Unit (ODU)		Existing Sewer Pipe								
	New HH Route 1		New Optical Distribution Unit (ODU)		Existing Stormwater Pipe								
	New HH Route 2		Core Drill		New Bosal or Agri Pipe								
	Existing Draw Box		Sprag		Existing Bosal or Agri Pipe								
	New Draw Box - Route 1		New Link Africa MH		New ATB								
	New Draw Box - Route 2		Existing Link Africa MH		New Client raiscom/ME1200								


SCALE:		PLANNED BY:		PROJECT No:		PROJECT DESCRIPTION:		Date Compiled
N.T.S. (Not To Scale)		Sibusiso Chiliza		99W0057239		Provide fibre Infrastructure from Link Africa Cabinet in the Telkom room to Gojiswa		2023/09/14
								Page 5 of 8


 




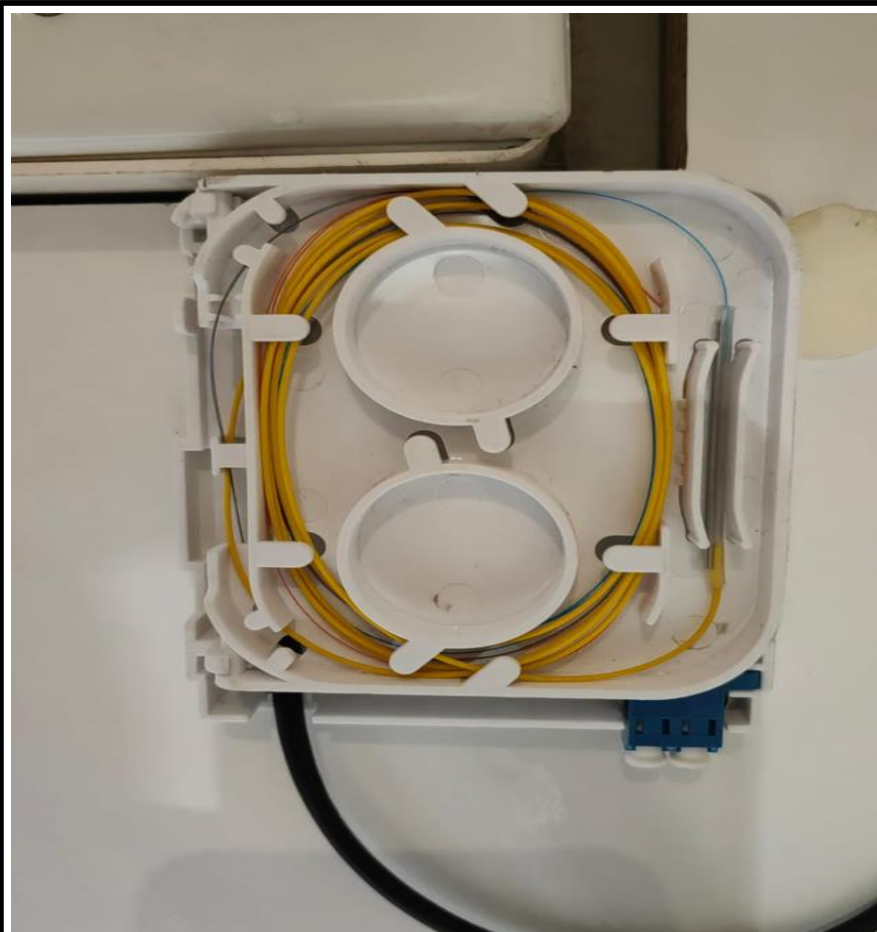



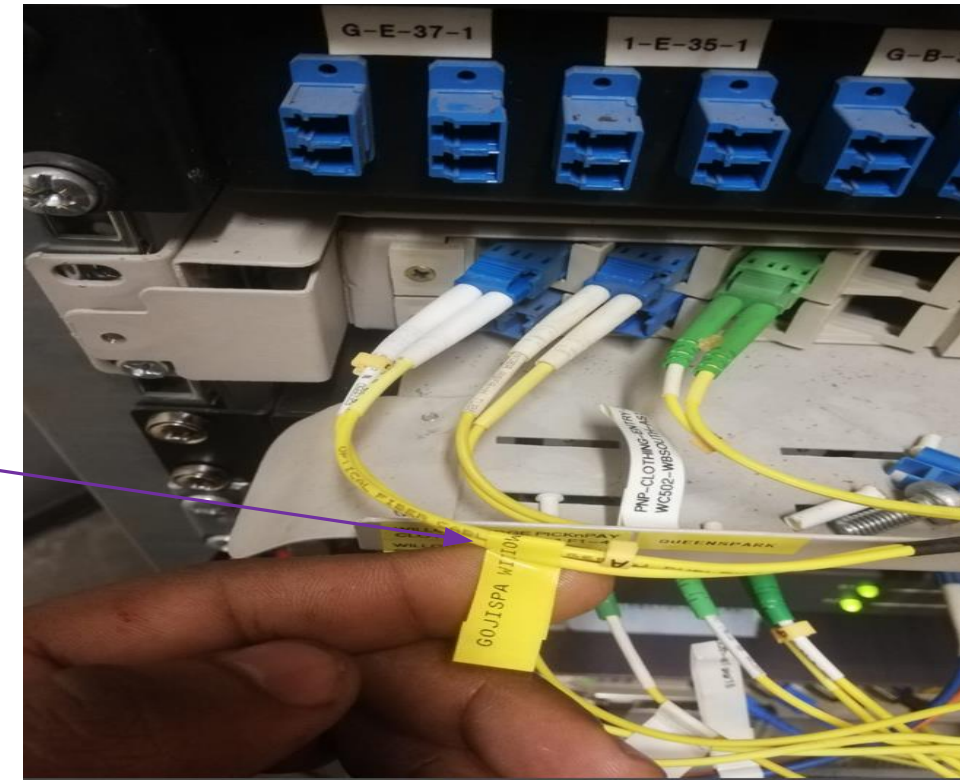



 








 







Color Legend						REVISION							REGION:
	Existing Access Fibre		Existing Fibre Distribution/Termination Point (FDP/FTP)		New Kicker Block	No.	NATURE OF REVISION	DATE	SIGNATURE	AUTHORITY			WC
	Proposed entry route 1 into building.		New Fibre Distribution/Termination Point (FDP/FTP)		Existing Kicker Block	1							
	Proposed entry route 2 into building.		Existing Junction Box		Existing Service Duct	2							
	Existing 3 rd Party Cable		New Junction Box		Existing LA Duct	3							
	Existing HH		Existing Optical Distribution Unit (ODU)		Existing Sewer Pipe	SCALE:		PLANNED BY:		PROJECT No:	PROJECT DESCRIPTION:	Date Compiled	
	New HH Route 1		New Optical Distribution Unit (ODU)		Existing Stormwater Pipe	N.T.S. (Not To Scale)		Sibusiso Chiliza		99W0057239	Provide fibre Infrastructure from Link Africa Cabinet in the Telkom room to Gojispa	2023/09/14	
	New HH Route 2		Core Drill		New Bosal or Agri Pipe							Page 6 of 8	
	Existing Draw Box		Sprag		Existing Bosal or Agri Pipe								
	New Draw Box - Route 1		New Link Africa MH		New ATB								
	New Draw Box - Route 2		Existing Link Africa MH		New Client raiscom/ME1200								



Power meter readings
ONT serial number
PON light
Patched at a node & labelled



Color Legend							REVISION					 	REGION: WC	
	Existing Access Fibre		Existing Fibre Distribution/Termination Point (FDP/FTP)		New Kicker Block		No.	NATURE OF REVISION	DATE	SIGNATURE	AUTHORITY			
	Proposed entry route 1 into building.		New Fibre Distribution/Termination Point (FDP/FTP)		Existing Kicker Block		1							
	Proposed entry route 2 into building.		Existing Junction Box		Existing Service Duct		2							
	Existing 3 rd Party Cable		New Junction Box		Existing LA Duct		3							
	Existing HH		Existing Optical Distribution Unit (ODU)		Existing Sewer Pipe		SCALE:		PLANNED BY:		PROJECT No:			PROJECT DESCRIPTION:
	New HH Route 1		New Optical Distribution Unit (ODU)		Existing Stormwater Pipe		N.T.S. (Not To Scale)		Sibusiso Chiliza		99W0057239			Provide fibre Infrastructure from Link Africa Cabinet in the Telkom room to Gojiswa
	New HH Route 2		Core Drill		New Bosal or Agri Pipe									
	Existing Draw Box		Sprag		Existing Bosal or Agri Pipe									
	New Draw Box - Route 1		New Link Africa MH		New ATB									
	New Draw Box - Route 2		Existing Link Africa MH		New Client raiscom/ME1200									