

ISP AS BUILT PLAN – Chateau Gateaux Tygervalley Shopping Mall

| Project Details | | Survey Date | 2023/06/01 |
|---|------------------|----------------|---------------------------|
| End-User Name | Chateau Gateaux | | |
| Link Africa Customer Name: | iTeam | | |
| | Name | Contact Number | Email Address |
| Representative: Link Africa Planner | Sibusiso Chiliza | 0711724267 | sibusiso@linkafrica.co.za |
| Representative: Link Africa Permissions | | | |
| Representative: Customer | | | |
| Representative: Landlord | | | |

ISP EXECUTIONS:

Fibre Route (Red)

- Install 108m x 1way duct from the passage behind iStore to Chateau Gateaux.
- Install 211m x 4f drop cable from ODB (splitter) to Chateau Gateaux.
- Splice F1 on the leg of 1:16 way splitter.
- Supply & label the cable and duct.
- Provide OTDR traces results.

Note: This project should be done in conjunction with Landlord & Client

AS BUILT PLAN



16-07-2023

Site Details

| | | | | | |
|-------------------|---|--------------|---------|-------------|--|
| Site Name: | Tygervalley Shopping Mall | | | | |
| Co-ordinates: | Latts: | -33,87370843 | Longs: | 18,63442445 | |
| Site Address: | Shop UL506C, Tyger Valley Shopping Centre | | | | |
| Suburb: | Bellville | | | | |
| Floor Number: | UL506C | Room Number: | | Site No.: | |
| Cabinet Position: | TBC | | | | |
| Building Name: | Tygervalley Shopping Mall | | Site ID | | |
| Site Type: | X | Single | | Duel | Site Location: Rooftop Green Field X In Building |
| Site Owner: | | | | | |

Possible concerns that must be flagged to Landlord/Customer

Customer deliverables:

- Personnel access to secure areas for build and maintenance phases.
- Permission for proposed construction.

Site Planning Approved by Landlord/Building Owner/Manager



Signature:



Name:










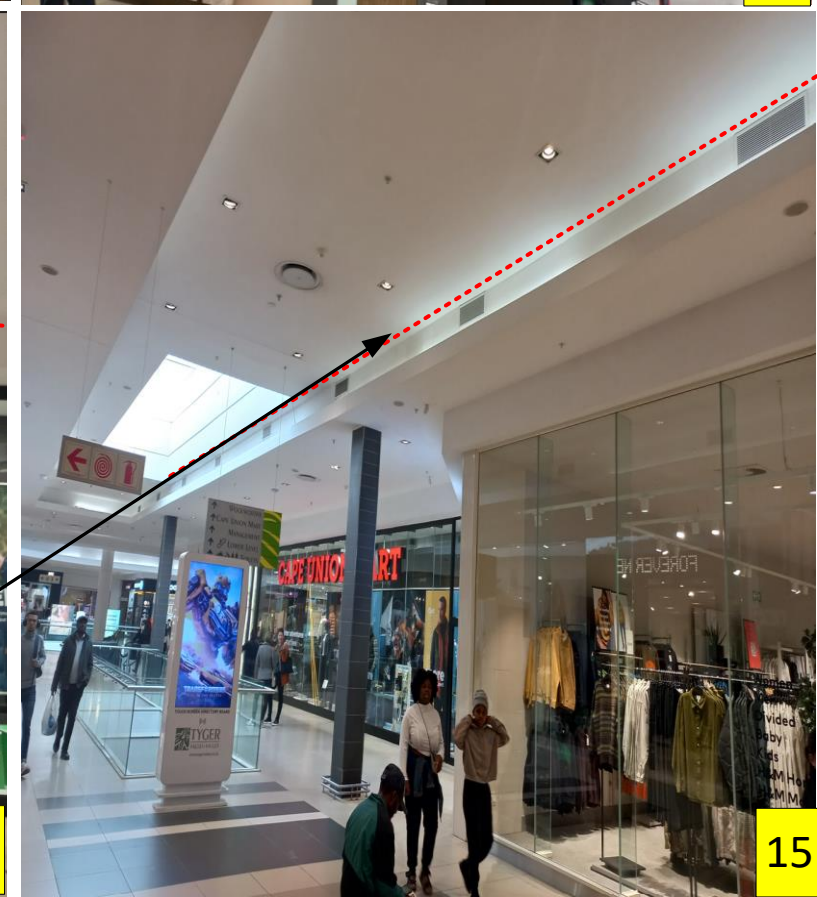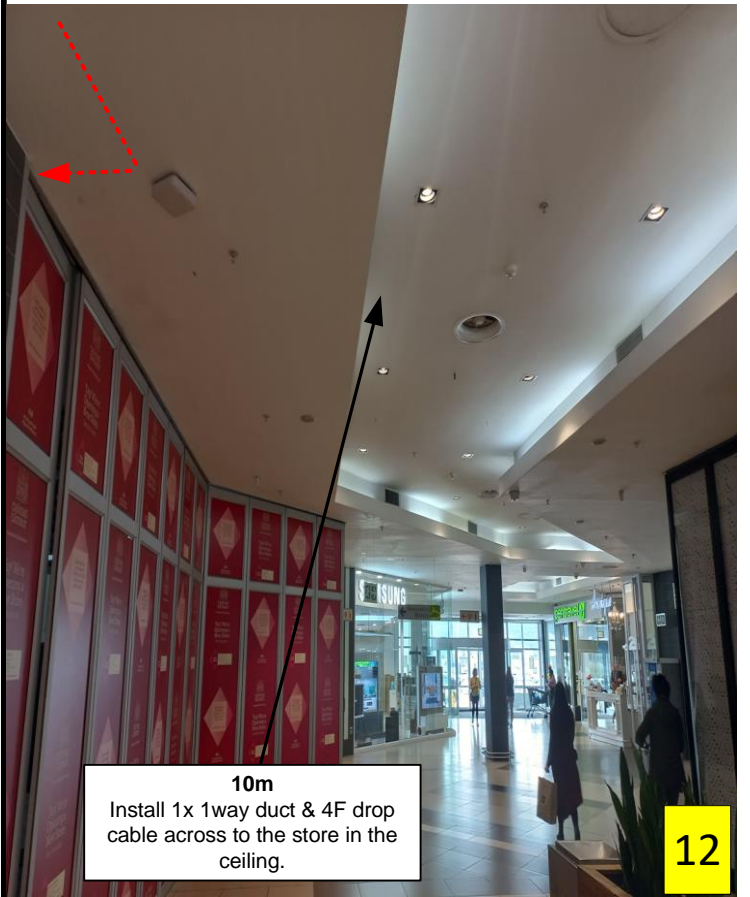

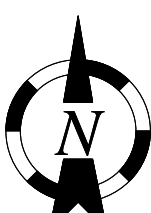






 














Designation:

Email.:

Contact No: Date:



| | | | | |
|---|-------------|--|---|-----------------------------|
| Planner Name | Project No: |  |  | Region |
| Sibusiso Chiliza | 66W0056628 | | | WC |
| PROJECT DESCRIPTION: Provide fibre Infrastructure from Link Africa 1:16 splitter behind iStore to Chateau Gateaux | | | | Date Compiled 2023/07/16 |
| | | Page 1 of 4 | | |



| Color Legend | | | | |  | REVISION | | | | |  |  | REGION: | |
|--|---------------------------------------|---|---|---|---|-----------------------------|--------------------------|--------------------|------------------|-----------|---|--|---------------|----|
|  | Existing Access Fibre |  | Existing Fibre Distribution/Termination Point (FDP/FTP) |  | | New Kicker Block | No. | NATURE OF REVISION | DATE | SIGNATURE | | | AUTHORITY | WC |
|  | Proposed entry route 1 into building. |  | New Fibre Distribution/Termination Point (FDP/FTP) |  | | Existing Kicker Block | 1 | | | | | | | |
|  | Proposed entry route 2 into building. |  | Existing Junction Box |  | | Existing Service Duct | 2 | | | | | | | |
|  | Existing 3 rd Party Cable |  | New Junction Box |  | | Existing LA Duct | 3 | | | | | | | |
|  | Existing HH |  | Existing Optical Distribution Unit (ODU) |  | | Existing Sewer Pipe | SCALE: | | PLANNED BY: | | PROJECT No: | PROJECT DESCRIPTION: | Date Compiled | |
|  | New HH Route 1 |  | New Optical Distribution Unit (ODU) |  | | Existing Stormwater Pipe | N.T.S. (Not To Scale) | | Sibusiso Chiliza | | 66W0056628 | Provide fibre Infrastructure from Link Africa 1:16 splitter behind iStore to Chateau Gateaux | 2023/07/16 | |
|  | New HH Route 2 |  | Core Drill |  | | New Bosal or Agri Pipe | | | | | | | Page 3 of 4 | |
|  | Existing Draw Box |  | Sprag |  | | Existing Bosal or Agri Pipe | | | | | | | | |
|  | New Draw Box - Route 1 |  | New Link Africa MH |  | | Client Cabinet | | | | | | | | |
|  | New Draw Box - Route 2 |  | Existing Link Africa MH |  | New Client raiscom/ME1200 | | | | | | | | | |



25m
Install 1way duct in the roof & haul 4f drop
cable in the store and leave (10m) slack
Note: Termination point to be confirm with
the client

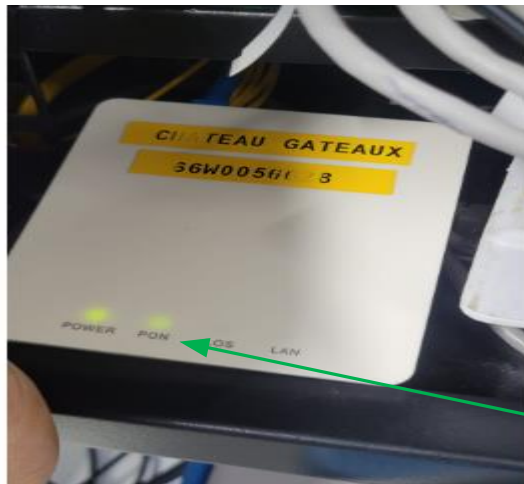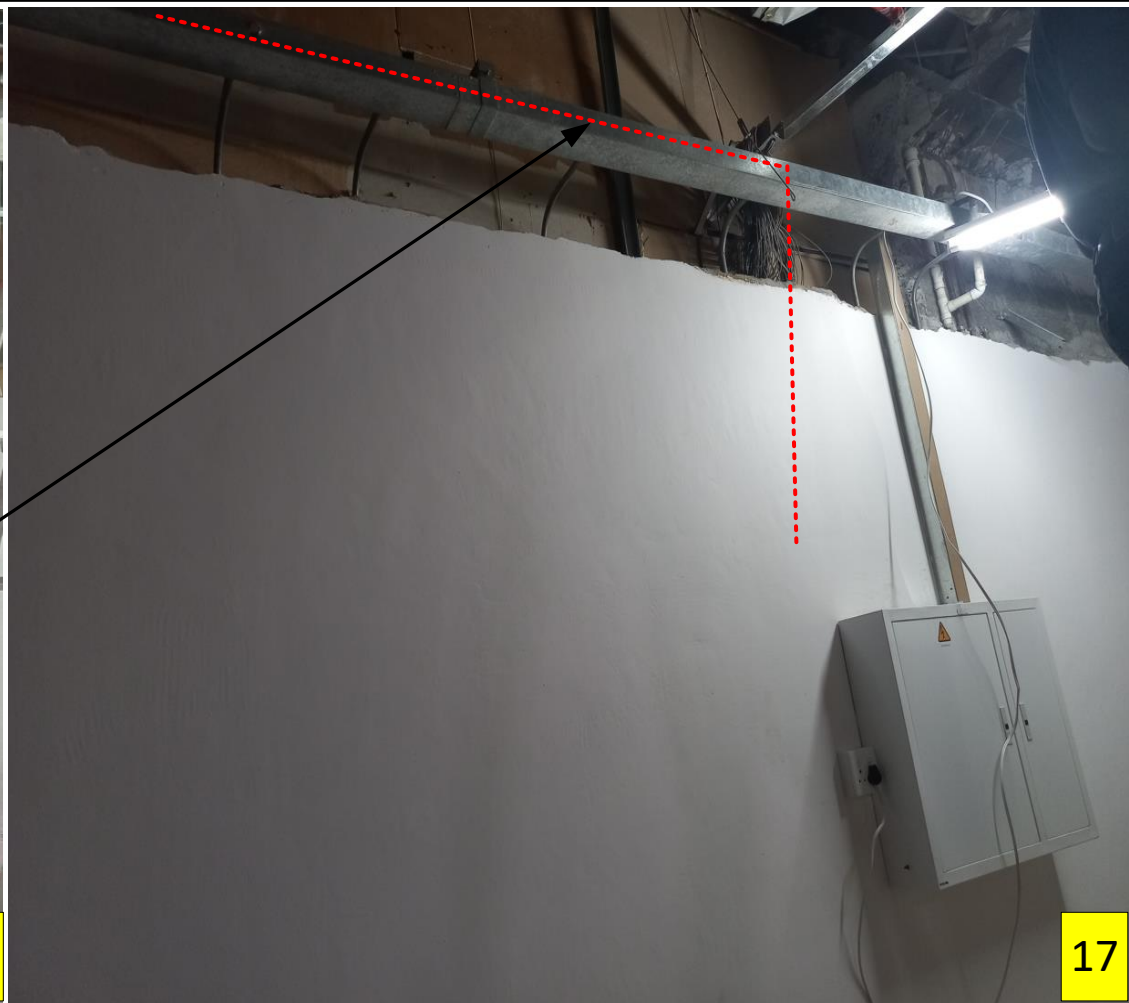

ONT PON Light & PON Number
Power Meter Readings

| Color Legend | | | | | | REVISION | | | | | iTEAM | link africa | REGION: WC |
|--------------|---------------------------------------|------|---|-----------|-----------------------------|----------|--------------------------|------------------|-------------|---|-------|-------------|-----------------------------|
| No. | NATURE OF REVISION | DATE | SIGNATURE | AUTHORITY | | | | | | | | | |
| — | Existing Access Fibre | ● | Existing Fibre Distribution/Termination Point (FDP/FTP) | ■ | New Kicker Block | 1 | | | | | | | |
| - - - | Proposed entry route 1 into building. | ○ | New Fibre Distribution/Termination Point (FDP/FTP) | ■ | Existing Kicker Block | 2 | | | | | | | |
| - - - | Proposed entry route 2 into building. | ⊠ | Existing Junction Box | — | Existing Service Duct | 3 | | | | | | | |
| — | Existing 3 rd Party Cable | ⊠ | New Junction Box | — | Existing LA Duct | | SCALE: | PLANNED BY: | PROJECT No: | PROJECT DESCRIPTION: | | | |
| ■ | Existing HH | E | Existing Optical Distribution Unit (ODU) | — | Existing Sewer Pipe | | N.T.S. (Not To Scale) | Sibusiso Chiliza | 66W0056628 | Provide fibre Infrastructure from Link Africa 1:16 splitter behind iStore to Chateau Gateaux | | | Date Compiled 2023/07/16 |
| □ | New HH Route 1 | ○ | New Optical Distribution Unit (ODU) | — | Existing Stormwater Pipe | | | | | | | | Page 4 of 4 |
| □ | New HH Route 2 | ○ | Core Drill | — | New Bosal or Agri Pipe | | | | | | | | |
| [] | Existing Draw Box | ○ | Sprag | — | Existing Bosal or Agri Pipe | | | | | | | | |
| □ | New Draw Box - Route 1 | ○ | New Link Africa MH | ■ | Client Cabinet | | | | | | | | |
| □ | New Draw Box - Route 2 | ○ | Existing Link Africa MH | ■ | New Client raiscom/ME1200 | | | | | | | | |