### ISP AS BUILT PLAN - PANAROTTI'S N1 CITY MALL

Project Details				Date	2023/09/13
End-User Name	Paranotti's				
Link Africa Customer Name:	Arcinternational				
	Name	Contact N	lumber		Email Addres
Representative: Link Africa Planner	Sibusiso Chiliza	071172426	7	sibusis	och@linkafrica.co.za
Representative: Link Africa Permissions					
Representative: Customer					
Representative: Landlord	Boyce Ndinga	+27 21 59	5 1170	BNding	ga@growthpoint.co.za

#### **ISP EXECUTIONS:**

#### Fibre Route (Red)

- Install 120m 1way micro duct in the roof and along the wall.
- Install 123m drop cable from ODB 2 in the passage by the control room to Panarotti's
- Label the duct & cable.
- Provide OTDR traces & Pictures

Note: This project should be done in conjunction with Landlord & Client

# AS\_BUILT PLAN

14-09-2023

Elinda

				Site	Deta	ails	<b>;</b>					
Site Name:	N1 CITY	MALL										
Co-ordinates:	Latts:	-33.8914	156		Longs	s:	18.560	64				
Site Address:	N1 City N	N1 City Mall, Louwtjie Rothman St, Goodwood										
Suburb:	GOODW	OOD										
Floor Number:	UL			Room N	umber	:			Site No.:			
<b>Cabinet Position:</b>	Wall Mou	ınted				·						
Building Name:	N1 CITY	MALL			Si	te ID						
Site Type:	X Sing	gle	Duel	Site Loc	ation:		Rooft	ор	Green F	ield	X	In Building
Site Owner:												
Possible concerns	that mus	t be flag	aed to L	andlord/C	ustom	er						

#### **Customer deliverables:**

- Personnel access to secure areas for build and maintenance phases.
- Permission for proposed construction.

#### Site Planning Approved by Landlord/Building Owner/Manager

Signature: .....

Name:

Designation:

Email.: .....

Contact No: Date:

Planner Name	Project No:
Sibusiso Chiliza	99W0057464

**PROJECT DESCRIPTION:** Provide fibre Infrastructure from Link Africa ODB-2 to Panarotti's





link afrıca

Region WC Date Compiled 2023/09/14

Page 1 of 6



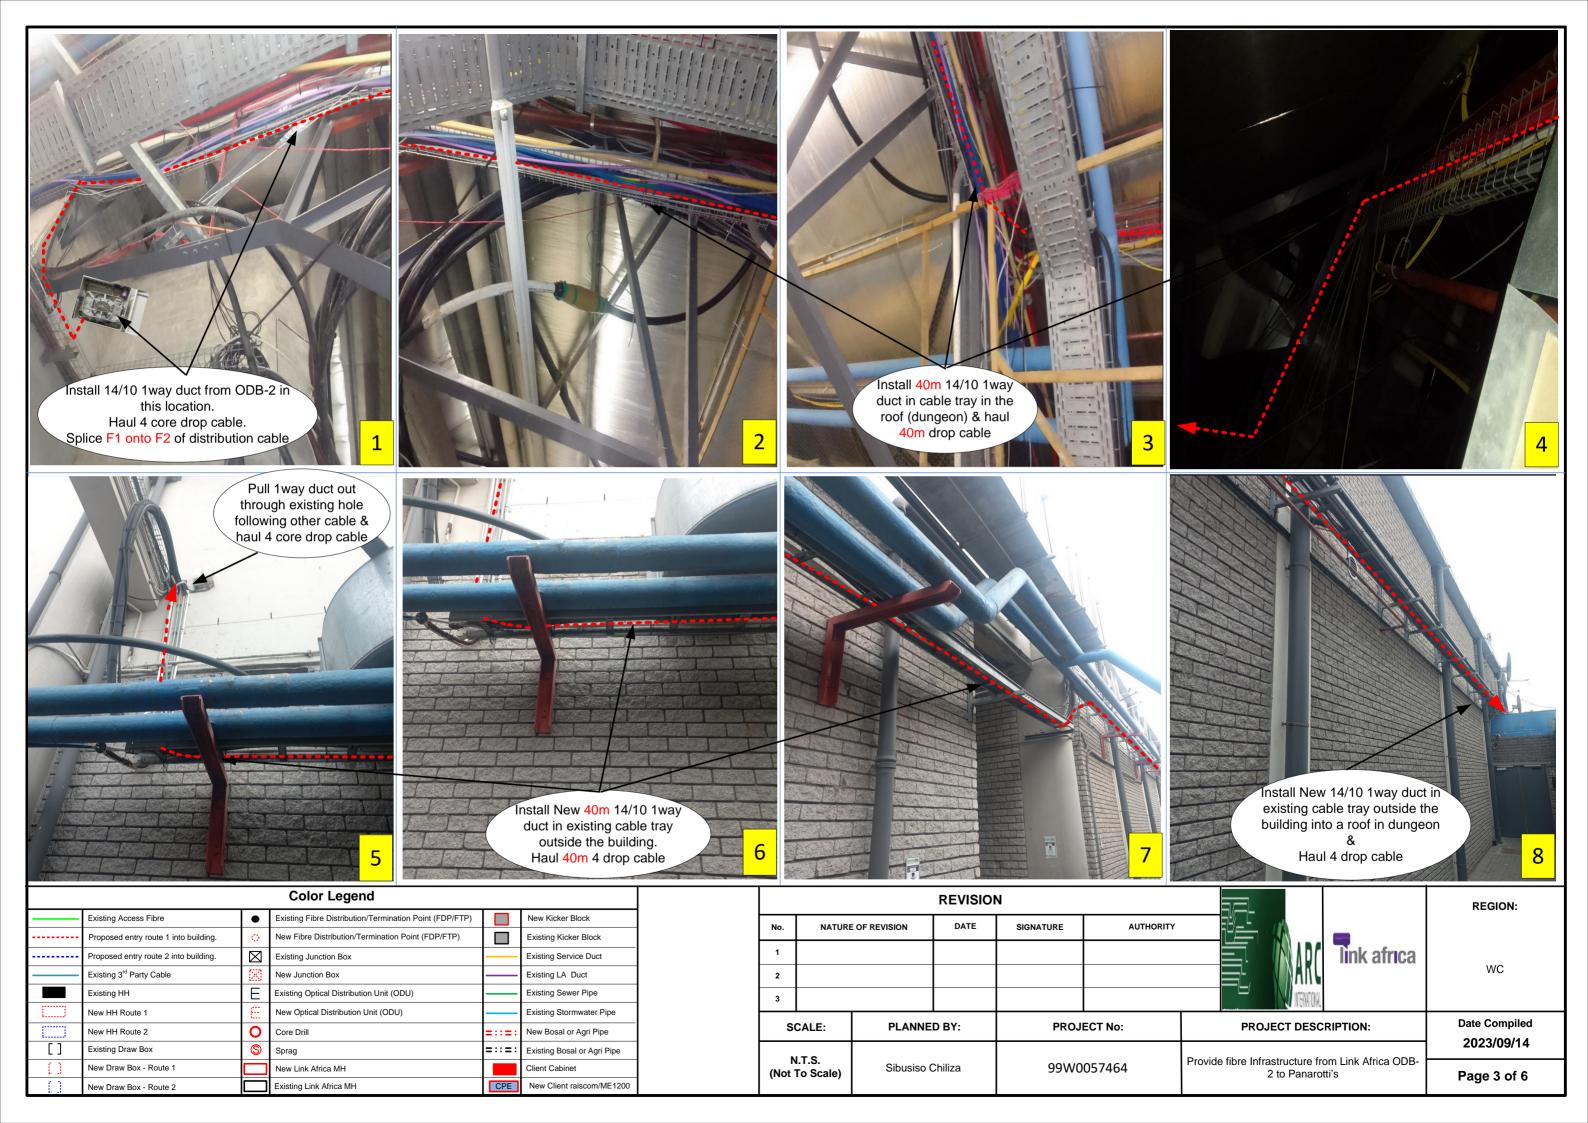

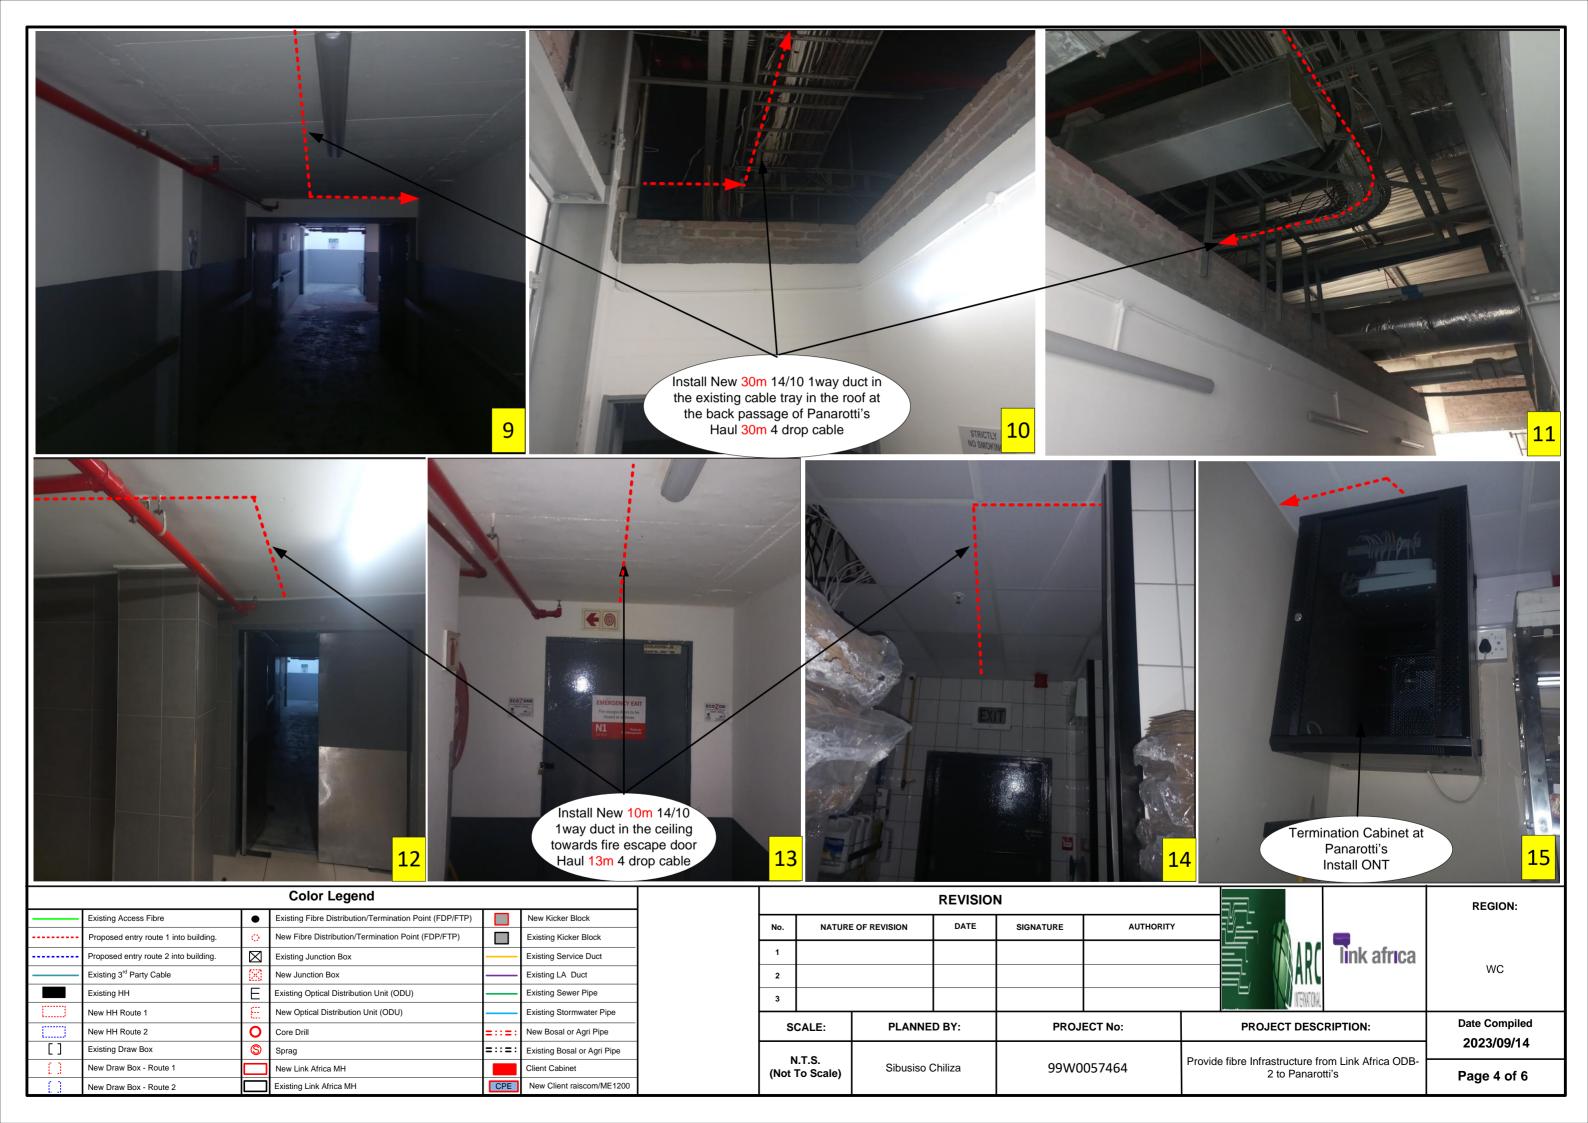

# OTDR Report (1625 nm (9 µm))

#### **General Information**

File name: 99W0057622 PANAROTTIS F1.trc

Test date: 2023-09-13 Customer: PANAROTTIS

Test time: 03:34:23 PM Company: LIBBY CONSTRUCTION

Cable ID: Fiber ID: F1

Job ID: Comments:

#### Locations


	Location A	Location B
Location		
Operator		
Model	FTB-7300E-234B-EA	
Serial number	507264	
Calibration date	2023-04-17 (UTC)	

#### Results

Span length: 0,1610 km Average loss: 0,149 dB/km Injection level: 17,8 dB

Span loss: 0,024 dB Average splice loss: --Span ORL: 50,82 dB Maximum splice loss: ---

#### Graph

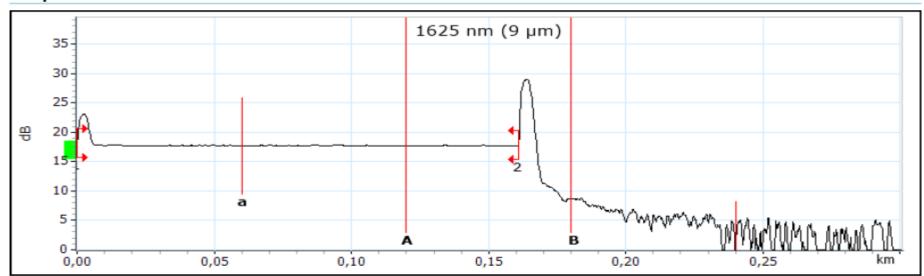

#### Markers

Marker	Position (km)	Value (dB)	A-B LSA attenuation:	83,624 dB/km	A-B average loss:	152,717 dB/km
а	0,0600	17,746	A-B LSA loss:	5,021 dB	4-point Event Loss:	9,592 dB
Α	0,1200	17,732	A-B ORL:	44,95 dB	Maximum reflectance:	-44,7 dB
В	0,1800	8,563				
b	0,2400	0,000				

#### **Event Table**

Туре	No.	Pos./Length (km)	Loss (dB)	Reflectance (dB)	Attenuation (dB/km)	Cumulative (dB)
First Connector	1	0,0000		-57,0		0,000
Section		0,1610	0,024		0,149	0,024
Reflective	2	0,1610		-44,7		0,024

Date: 9-13-2023



Signature:

Page 1 of 2

## OTDR Report (1625 nm (9 µm))

#### Macrobend

Position (km)	Delta Loss (dB)

#### Pass/Fail Thresholds

1625 nm (9 µm)

#### **Test Parameters**

	$A \rightarrow B$
Wavelength (nm)	1625 nm (9 µm)
Range (km)	0,3000
Pulse (ns)	30
Duration (s)	15

#### Test Settings

	$A \rightarrow B$	Macrobend Wavelengths	Macrobend Delta Loss (d
IOR	1,468734		
Backscatter (dB)	-82,59		
Helix factor (%)	0,00		
Splice loss detection threshold (dB)	0,150		
Reflectance detection threshold (dB)	-72,0		
End-of-fiber detection threshold (dB)	5,000		